

Date: Wednesday, 6/14/2006 1:05:52 PM
 User: [redacted]@celle

Process Sheet

Customer :	CU-DAR001 Dart Helicopters Services	Drawing Name :	DUMP OUTLET					
Job No. :	27543							
Estimate Number :	12131							
Part Number :	NIA	Part Number :	D34757					
Issue :	6/14/2006	S.O. No. :	NIA					
Issue Rev. :	NC	Drawing Number :	D3475 REV B					
First Issue :	NIA	Project Number :	N/A					
Previous Run :	26176	Drawing Revision :	B					
	Type : SMALL /MED FAB	Material :	NIA					
Written By :	SEE COMMENT BELOW		Due Date :	6/16/2006	Qty:	10	Um:	Each
Checked & Approved By :								
Comment :	Est Rev:A New Issue 06-01-31 JLM Est Rev:B As per Rev B 06-05-24 JLM							

Additional Product

Job Number:



Seq. #:	Machine Or Operation:	Description :
---------	-----------------------	---------------

1.0	PG	PURCHASING
-----	----	------------



Comment: PURCHASING

Issue P/O: 1308 For D3475-7S

Spin as per Dwg D3475

Possible Supplier: SIEG

Material release note is required

C 205/30/06

2.0	D3475S	SCOOP OUTLET SPINNING DETAIL
-----	--------	------------------------------



Comment: Qty.: 1.0000 Each(s)/Unit Total : 10.0000 Each(s)
 scoop outlet

3.0	PACKAGING 1	PACKAGING RESOURCE #1
-----	-------------	-----------------------



Comment: PACKAGING RESOURCE #1

Receive & Inspect For Transit Damage

Ensure material certification is attached

C 206/04/06

(10)

4.0	QC6	DIMENSIONAL CHECK
-----	-----	-------------------



Comment: DIMENSIONAL CHECK

Sp 06/06/14

5.0	SMALL FAB 1	SMALL & MEDIUM FAB RESOURCE 1
-----	-------------	-------------------------------



Comment: SMALL & MEDIUM FAB RESOURCE 1

1-Scribe line at .180" Below center line of part

2-Rough Cut Part on Band Saw Leaving some Material.

06.06.16 10

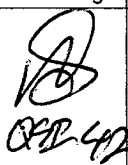

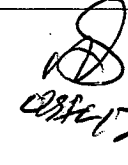
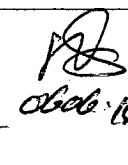
POSITIVE
RECALL
Proceed
to step 5

(10)

Dart Aerospace Ltd

W/O:		WORK ORDER CHANGES					
DATE	STEP	PROCEDURE CHANGE	By	Date	Qty	Approval Chief Eng / Prod Mgr	Approval QC Inspector

Part No: _____ PAR #: _____ Fault Category: _____ NCR: Yes ☒ No ☐ DQA: ☒ ☐ Date: 06/06/16
 QA: N/C Closed: _____ Date: _____

NCR:		WORK ORDER NON-CONFORMANCE (NCR)						
DATE	STEP	Description of NC Section A	Corrective Action Section B			Verification Section C	Approval Chief Eng	Approval QC Inspector
			Initial Chief Eng	Action Description Chief Eng	Sign & Date			
06/06/16	5	1 piece the angles was 15° has to be 10°	 06/06/16	Scrap + destroy	SB 06/06/15	 06/06/16	 06/06/16	 06/06/16

NOTE: Date & initial all entries

Date: Wednesday, 6/14/2006 1:05:53 PM
User: Linda Lacelle

Process Sheet

Customer: CU-DAR001 Dart Helicopters Services

Drawing Name: DUMP OUTLET

Job Number: 27543

Part Number: D34757

Job Number:



Seq. #:

Machine Or Operation:

Description :

3-Using DT8842 Angle Block,Sand Part on Disk Sander to Scribed line.

4-Transfer Punch Using DT8843,Then Drill as per Dwg D3475.

5-Deburr.

FF 06.06.16 12

6.0

QC5

INSPECT WORK TO CURRENT STEP



Comment: INSPECT WORK TO CURRENT STEP

06.06.16 SB 06/06/16 (9) PTO

7.0

PACKAGING 1

PACKAGING RESOURCE #1



Comment: PACKAGING RESOURCE #1

Identify and Stock

Location: _____

06/06/16 (9)

8.0

DC

DOCUMENT CONTROL



Comment: DOCUMENT CONTROL

Inspection Level 21

06.06.16 (9)
06/06/16

Job Completion



POSITIVE RECALL

EFFECTIVE 06-06-14 AUTH [Signature]

RELEASED [Signature] DATE 06-06-16

06/06/14
Proceed to Step 5.2

Dart Aerospace Ltd

W/O:		WORK ORDER CHANGES					
DATE	STEP	PROCEDURE CHANGE	By	Date	Qty	Approval Chief Eng / Prod Mgr	Approval QC Inspector

Part No: _____ PAR #: _____ Fault Category: _____ NCR: Yes No DQA: _____ Date: _____

QA: N/C Closed: _____ Date: _____

NCR:		WORK ORDER NON-CONFORMANCE (NCR)						
DATE	STEP	Description of NC Section A	Corrective Action Section B			Verification Section C	Approval Chief Eng	Approval QC Inspector
			Initial Chief Eng	Action Description Chief Eng	Sign & Date			

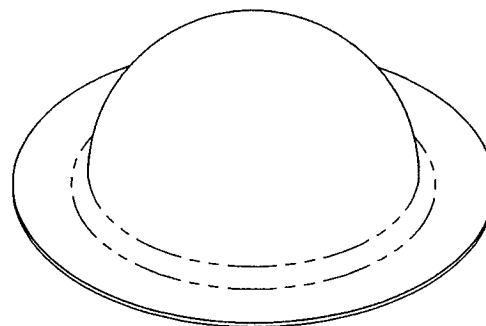
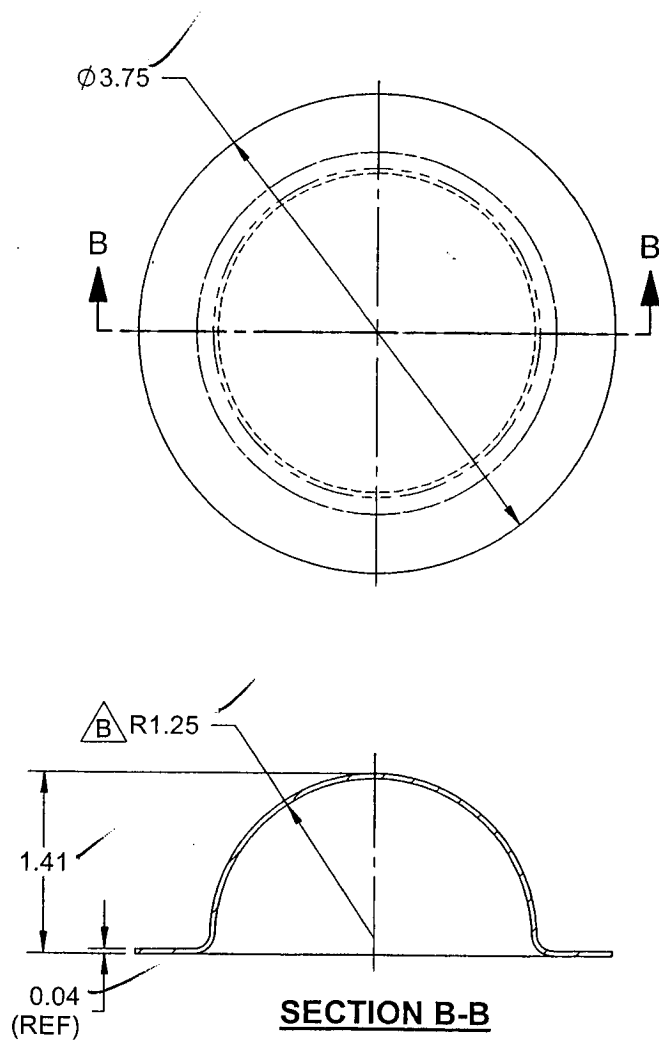
NOTE: Date & initial all entries



DESIGN 13	DRAWN BY 13	DART AEROSPACE LTD HAWKESBURY, ONTARIO, CANADA	
CHECKED [Signature]	APPROVED [Signature]	DRAWING NO. D3475	REV. B SHEET 5 OF 7
DATE 06.05.16		TITLE DUMP OUTLET	SCALE 1:1.5

RELEASED
06.05.16 [Signature]

REFERENCE ONLY



D3475-7S SCOOP OUTLET, SPINNING DETAIL

NOTES:

- 1) MATERIAL: 2024-0 ALUMINUM SHEET, 0.040" THICK PER AMS-QQ-A-250/4 OR AMS 4037 (REF. DART SPEC. M2024T0S.040)
- 2) TOLERANCES ARE PER DART QSI 018 UNLESS OTHERWISE NOTED
- 3) ALL DIMENSIONS ARE IN INCHES
- 4) BREAK ALL SHARP EDGES 0.005 TO 0.010

COPYRIGHT © 2006 BY DART AEROSPACE LTD.

THIS DOCUMENT IS PRIVATE AND CONFIDENTIAL AND IS SUPPLIED ON THE EXPRESS CONDITION THAT IT IS NOT TO BE USED FOR ANY PURPOSE OR COPIED OR COMMUNICATED TO ANY OTHER PERSON WITHOUT WRITTEN PERMISSION FROM DART AEROSPACE LTD.

06/15/2008 12:13 FAX 6045307490
06/15/2008 THU 10:36 FAX

Sieg's Mfg. Ltd.

0001
001/004

CUSTOMER 02510		SHIP DATE 02/17/06 SHP		GROSS WEIGHT 211		QUOTE 38-259436-1		OF 1		PACKING LIST	
BILL TO SIEGS MANUFACTURING LTD.		WORK ORDER ***		ORDER DATE 02/03/06 ORD		DELIVERY DATE 02/17/06 DEL		SHIP BRANCH 38 (17)		TEST RESULTS	
SIEGS MANUFACTURING LTD. 6236 - 205 STREET LANGLEY BC CANADA		V2Y 1N7		01		19044 95A AVENUE, BERRY BRITISH COLUMBIA, CANADA VAN		38-VAN		UY2370	
CUSTOMER P.O. NUMBER ARLA		TERRITORY 02		ENTRY ID 38JJD		Copper and Brass Sales Canada A ThyssenKrupp Materials NA Company ThyssenKrupp					
BUYER ARLA		INSIDE SALES JOE J. DILLIELLO		INVENTORY 26.78 LB		BILLING 1.00 PC		27.00		1.00	
BUYER TELEPHONE (604) 530-7455		INSIDE SALES TELEPHONE (604) 882-3493 223		WAREHOUSE							
INTERNAL		COMPLETE X		PARTIAL		CANCEL					
TO CUSTOMER OUR TRUCK/FRT-BESTWAY-JAG1		FOR ORIG		PACKED WITH OTHER GOODS							
BILL OF LADING		FREIGHT STATUS PPD		FINISHED GOODS LOCATION		WARN LABEL: 1005					
AIRCRAFT QUALITY 2024-O CLAD ALUM SHEET, .040 X 48 X 144 -SIEGS MANUFACTURING LTD. ***, NO PROCESSING - 48" X 144" Mill Dimensions., PVC Clear 1 Side. Test Results Attn to: QA Department. , **ok to ship as per P Walsh **all sheets, must be squared and flat on each skid-please ensure each skid has 2 X 4 , legs cut and placed on bottom of skid (along 48" width) for easy forklift , access. **each size to be sep. on indiv.											
FULL											
CUSTOMER RECEIVING HOURS 7-3:30pm, avoid 11:3		MAX SKID WEIGHT 3000		LOADING INSTRUCTIONS FORK		MAXIMUM SKID WEIGHT 3000					
BOXES		UNITS		CASES		CUP-UP		PKGS		SKIDS	

TEST RESULTS

CERTIFICATE OF COMPLIANCE

We hereby certify that mercury or any of its compounds are not used in the processing and distribution of our products. The products we distribute are not hazardous in their received state. For MSDS sheets go to www.copperandbrass.com/msds or call 248-233-5682. We hereby certify that the material above complies with the following specifications:

QQ-A-250/5

AMS 4040

ASTM-B209

TAC NO QUANTITY UOM VENDOR VEND PO HEAT/LOT
1.00 PC ALCOA I 08G6265 533531

PCS : TAC NO

QUANTITY UOM VENDOR VEND PO HEAT/LOT

PCS

DAVID K. BARESH

General Manager, VANCOUVER
COPPER AND BRASS SALES CANADA IS A DIVISION OF THYSSENKRUPP MATERIALS, CA, LTD./USA

PRINTED 02/15/06 11:56 AM

CONTROL NO 00082

Dant.
613-632-1053 4 Pages

ATTN: Gerry
604-530-7490

CERTIFIED INSPECTION REPORT

Alcoa Inc.

PITTSBURGH, PA DAVENPORT WORKS

Ship From: RIVERDALE, IA.

We hereby certify that the material covered by this certificate has been inspected and has been found to meet the applicable requirements described therein, including any specifications forming a part of the description and that samples representative of the material and the composition have been taken and the mechanical properties shown on the face of this sheet.

Mark J. Venable

Mark J. Venable
Director of Manufacturing Davenport Works

Kurt F. Young

Kurt F. Young
Quality Assurance Manager

205131
Ship Date

2003-01-10

P.O. No./Govt Contract No.

866265

9050
B.L. No.

24546

Invoice No.

56912

Customer

C&B-WALLINGFORD

Alcoa No. Item

DS-56734-1

Page 1

Ship To: COPPER & BRASS SALIS INC
WALLINGFORD BRANCH
5 SPERLING DRIVE
WALLINGFORD, CT 06492

Item Description

.040 IN TH (+.0000 -.003) X 48 IN W X 144
IN LN (N) A/T ALCLAD 2024-O FLAT SHEET MILL FINISH (PART 752603-
1) RAMMA 02-182-030, PER(EXT GA TOL) AMS-QQ-A-
250/5 REV A & EXCEPT MARKING
ASTM B209 REV 02 & EXCEPT MARKING AMS4040 REV M
({MARKED}) INTERLEAVED MAX GROSS
SKID WGT: 2400 LB QUAN TOL +/-30 %
CQR 0137587 REV 01 QRR 000879 CUST REQ 02-12-
15 *** W/R 02-12-21 ***

Num	Package Ticket	Lot	Weight	Quantity	UOM	Pc Id/Serl
1	639714	533531	2035	77	PC	
2	639810	533531	795	30	PC	
3	639812	533531	2011	77	PC	
4	639813	533531	2115	81	PC	
5	639814	533531	2039	77	PC	
			8995	342		

Notes for CQR: 0137587.1

PRODUCT PRODUCED AND MARKED TO THE REQUIREMENTS OF AMS-QQ-A-250/5 ALSO MEETS THE REQUIREMENTS OF QQ-A-250/5F, AMENDMENT 2.
PRODUCT PRODUCED AND MARKED TO THE REQUIREMENTS OF QQ-A-250/5F, AMENDMENT 2 ALSO MEETS THE REQUIREMENTS OF AMS-QQ-A-250/5.

CQR: 0137587.1 -Specification Limits

Temp	Dir	UTS	TYS	ELAD
0	Long Transv.	Max	30.0	14.0
		Min		12
Temp	Dir	UTS	TYS	ELAD
T42	Long Transv.	Max	57.0	34.0
		Min		15
Temp	Dir	UTS	TYS	ELAD
T42P	Long Transv.	Max	57.0	34.0
		Min		15



SIKORSKY

CERTIFIED INSPECTION REPORT

Alcoa Inc.

PITTSBURGH, PA DAVENPORT WORKS

Ship From: RIVERDALE, IA.

We hereby certify that the material covered by this cert. has been inspected with, and has been found to meet, the applicable requirements described herein, including any specifications forming a part of the description and that samples representative of the material and the composition limits and have the mechanical properties shown on the face of this sheet.

*Mark J. Vrabec*Mark J. Vrabec
Director of Manufacturing Davenport Works*Kenton P. Young*Kenton P. Young
Quality Assurance Manager205133
Ship Date9050
B.L. No.

Invoice No.

Alcoa No. Item

Page 2

2003-01-10

24546

56912

DS-56734-1

P.O. No./Govt Contract No.

Customer

066265

C&B-MALLINGFORD

CQR: 0137587.1 -Specification Limits (cont.)

Temp	Dir	UTS	TYS	ELAD
T62	Long Transv.	RSI	KSI	PCT
	Max			
	Min	60.0	47.0	5

Chemical Composition	SI	FE	CU	MN	MG	CR	ZN	TI	Other	Other	
									Each	Total Aluminum	
Alloy 2024	Max	.50	.50	4.9	.9	1.8	.10	.25	.15	.05	.15
	Min			3.8	.30	1.2					REMAIN

Chemical Composition	SI+FE	CU	MN	MG	V	ZN	TI	Other
LINER								Each Aluminum
Alloy 1230	Max	.70	.10	.05	.05	.10	.03	.03
	Min							99.30

Lot: 533531 -Mechanical, Physical, Metallography, Quantometer Results

Temp	Dir	No.	UTS	TYS	ELAD
0	Long Transv.	Test	KSI	KSI	PCT
	Max	2	23.4	12.5	20
	Min		23.4	11.4	20

Temp	Dir	No.	UTS	TYS	ELAD
T42	Long Transv.	Test	KSI	KSI	PCT
	Max	2	60.8	37.6	24.5
	Min		60.5	37.5	19.5

Temp	Dir	No.	UTS	TYS	ELAD
T42P	Long Transv.	Test	KSI	KSI	PCT
	Max	2	62.5	38.4	27
	Min		62.4	38.2	25

Temp	Dir	No.	UTS	TYS	ELAD
T62	Long Transv.	Test	KSI	KSI	PCT
	Max	2	61.8	49.4	9.5
	Min		61.6	48.9	9

CERTIFIED INSPECTION REPORT

Alcoa Inc.

PITTSBURGH, PA DAVENPORT WORKS

Ship From: RIVERDALE, IA.

Page 3

We hereby certify that the material examined by this certificate has been inspected, and has been found to meet the applicable requirements described herein, including any specifications forming a part of the description and the samples received from the material in the condition in which it was received. This inspection is not a guarantee of the quality of the material.

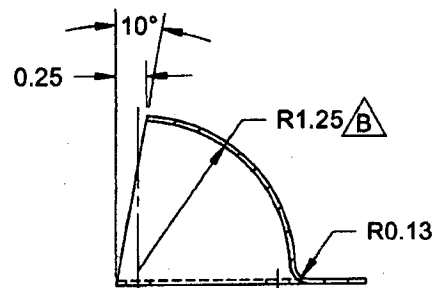
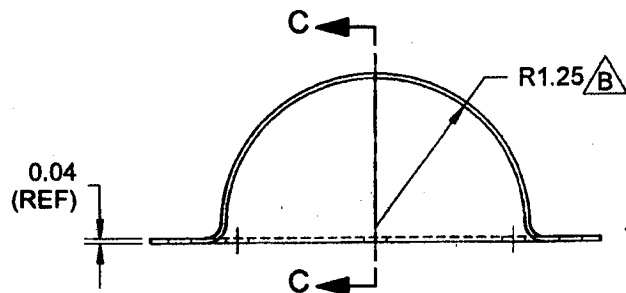
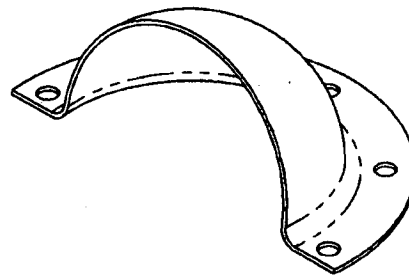
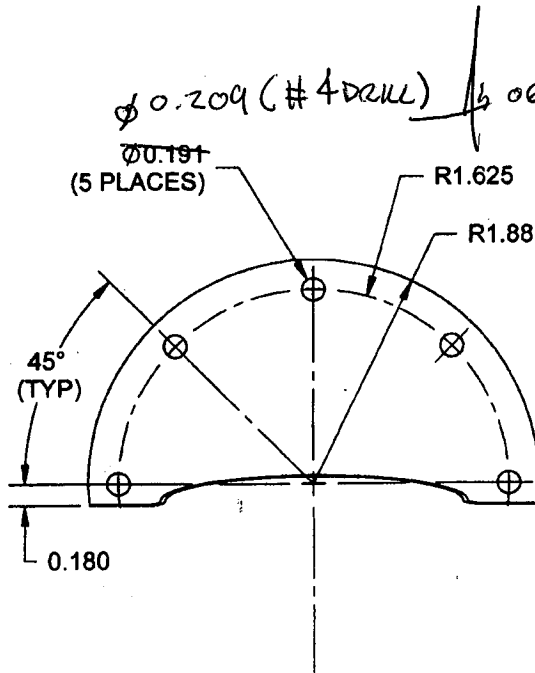
Mark Baker
Director of Manufacturing Inspection Works
Ken P. Young
Ken P. Young
Quality Assurance Manager

205131
Ship Date
2003-01-10
B.I. No. 24546
Invoice No. 56512
Alcoa No. Item
DS-56734-1
Customer
CSB-WALLINGFORD
806265

Lot: 533531 - Mechanical, Physical, Metallurgy, Quantometer Results (cont.)
Cast Number Chemical ST PE CU H9532815
Actuals .07 .17 4.6 .64 1.6 .01 .10 .03

DART

DESIGN <i>[Signature]</i>	DRAWN BY <i>[Signature]</i>	DART AEROSPACE LTD HAWKESBURY, ONTARIO, CANADA	
CHECKED <i>[Signature]</i>	APPROVED <i>[Signature]</i>	DRAWING NO. D3475	REV. B SHEET 6 OF 7
DATE 06.05.16		TITLE DUMP OUTLET	SCALE 1:1.5

**SECTION C-C****D3475-7 SCOOP OUTLET****NOTES:**

- 1) MATERIAL: MAKE FROM D3475-7S
- 2) IDENTIFY WITH DART P/N D3475-7 USING FINE POINT PERMANENT INK MARKER
- 3) TOLERANCES ARE PER DART QSI 018 UNLESS OTHERWISE NOTED
- 4) ALL DIMENSIONS ARE IN INCHES
- 5) BREAK ALL SHARP EDGES 0.005 TO 0.010

COPYRIGHT © 2006 BY DART AEROSPACE LTD.

THIS DOCUMENT IS PRIVATE AND CONFIDENTIAL AND IS SUPPLIED ON THE EXPRESS CONDITION THAT IT IS NOT TO BE USED FOR ANY PURPOSE OR COPIED OR COMMUNICATED TO ANY OTHER PERSON WITHOUT WRITTEN PERMISSION FROM DART AEROSPACE LTD.